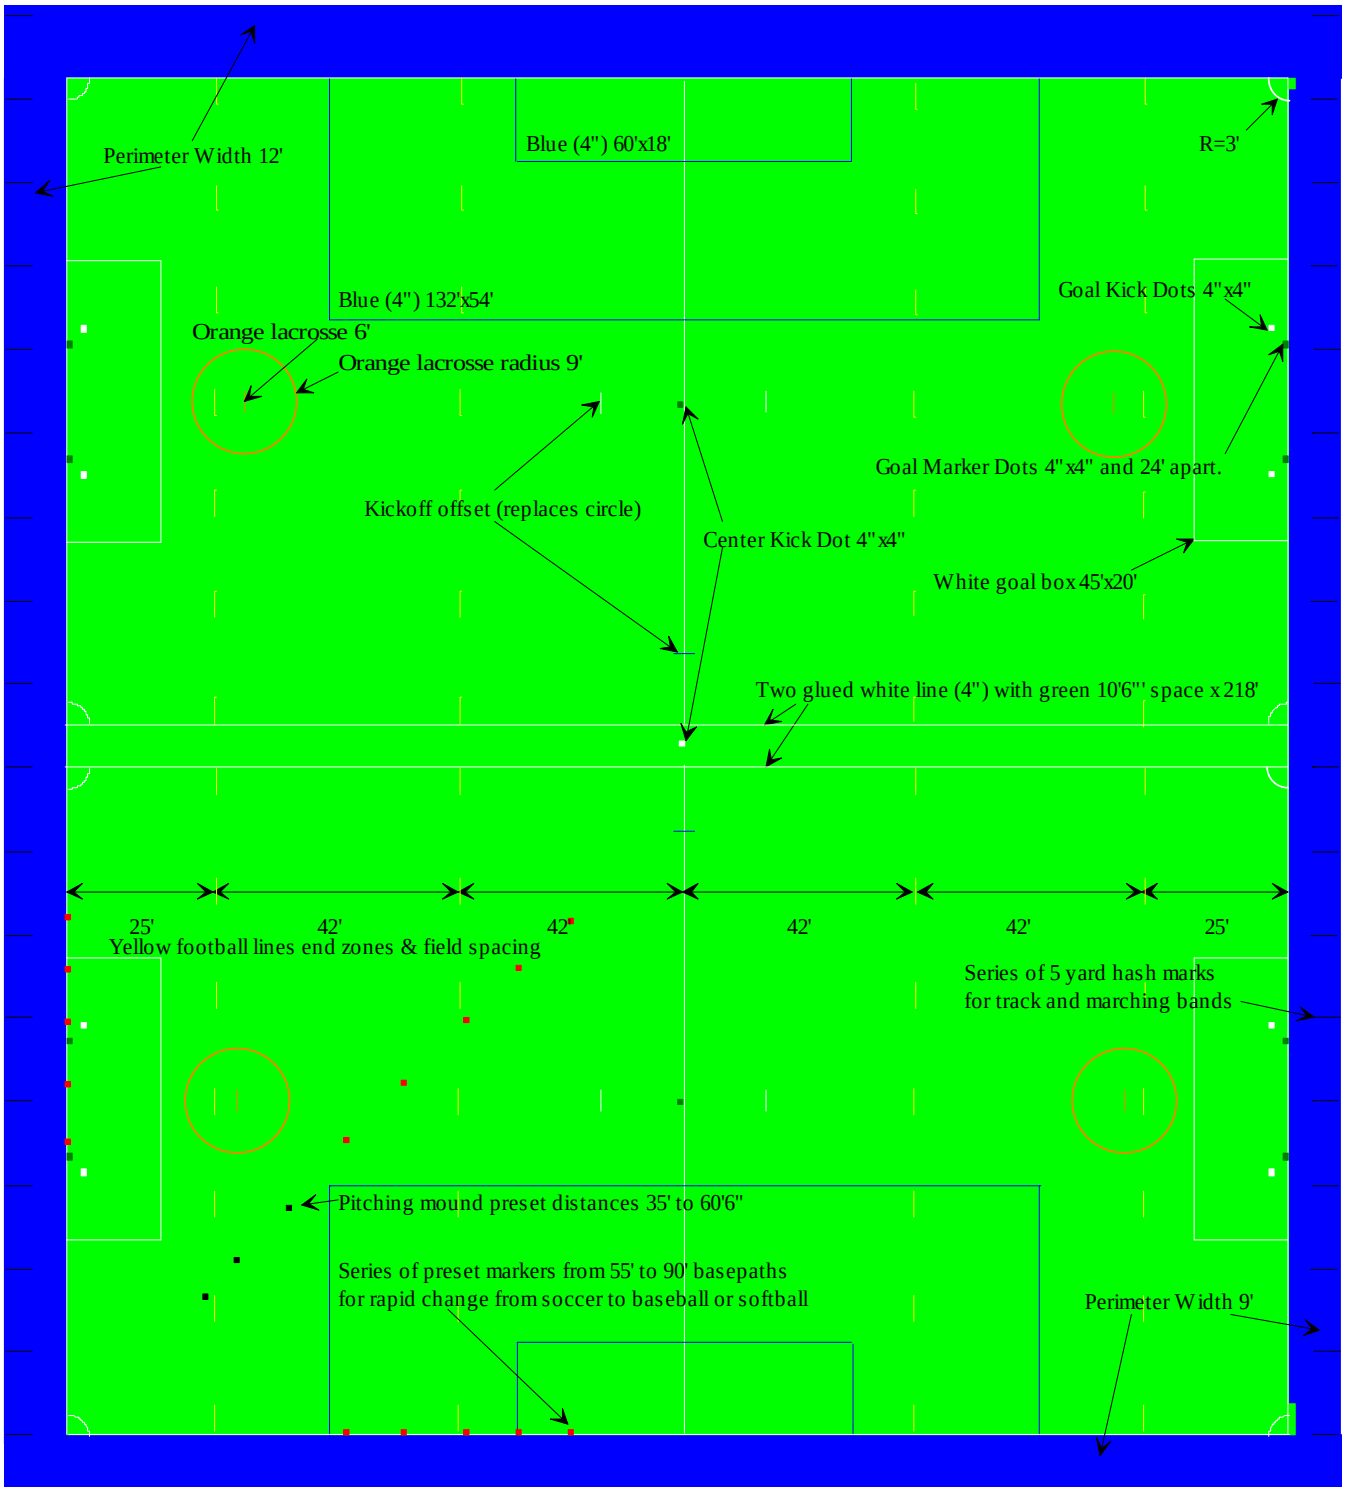Oakland Yard South Dome Field
Design Layout - Installed 2009